




United Business Media

City Reach
Millharbour
Isle of Dogs
LONDON
E14 9NN

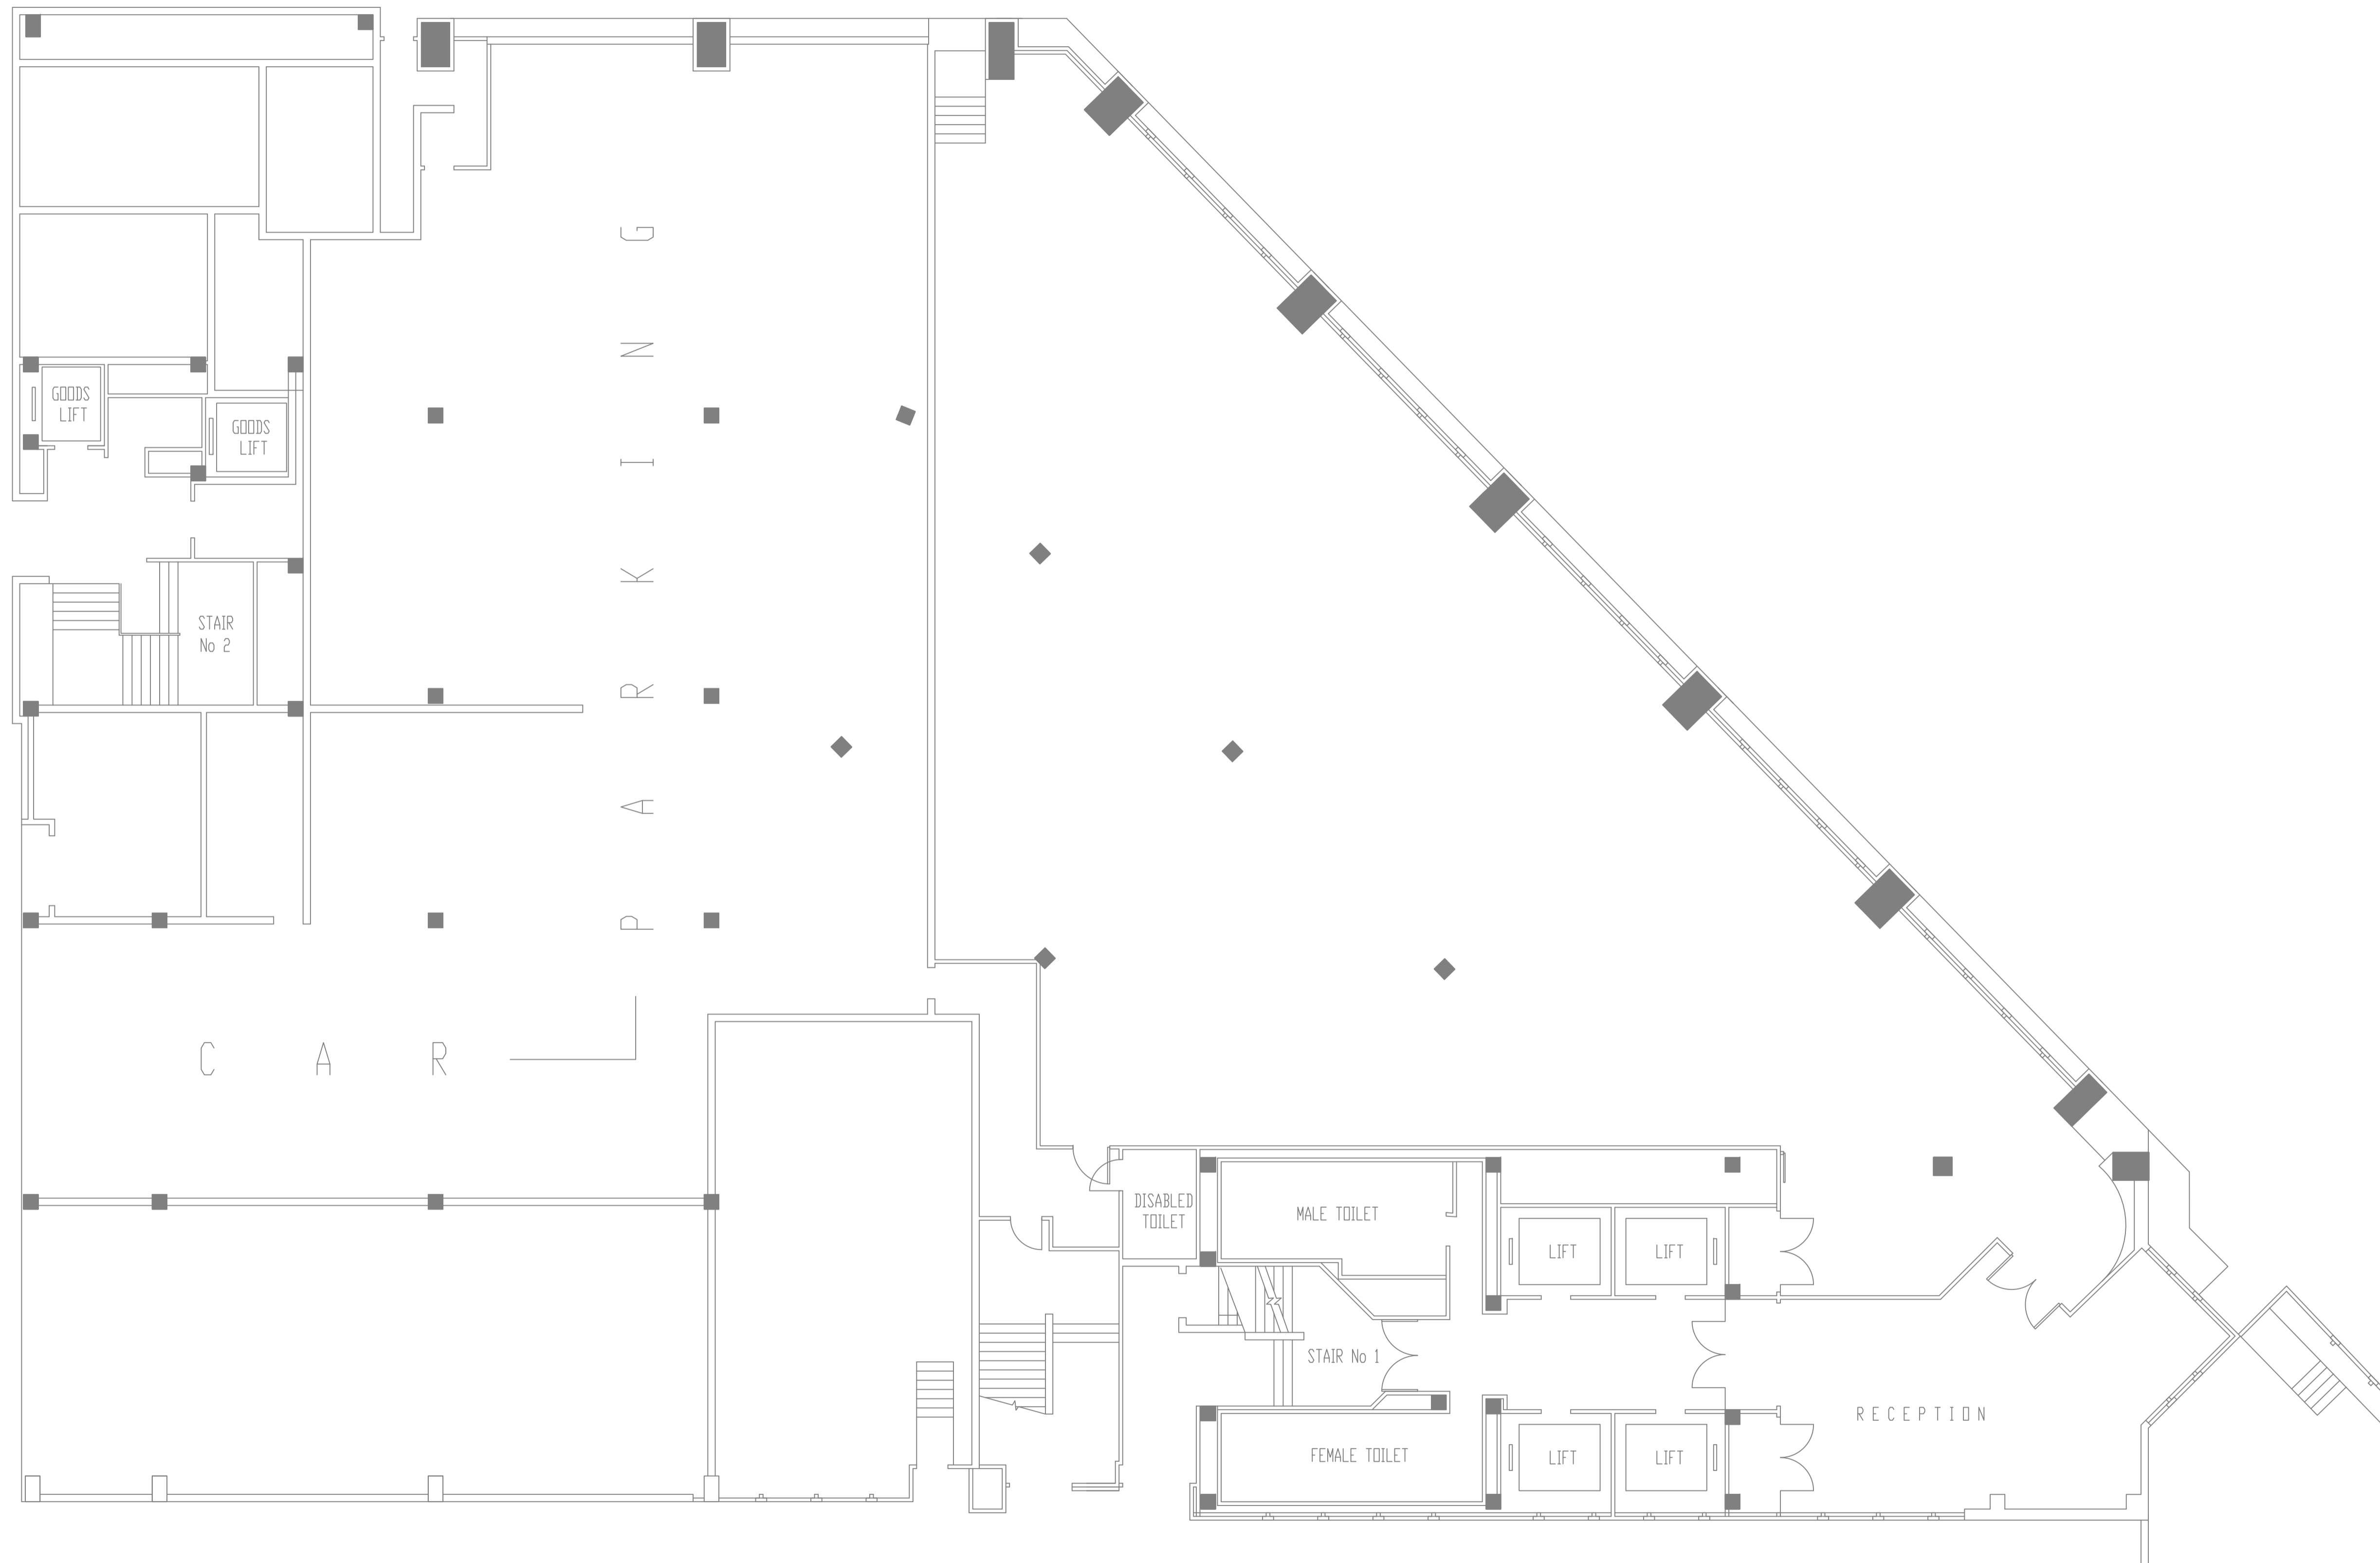

Revisions
A - As Built amendments: Curve added at entrance doors - 11.08.03

Bollingbrook

Maritime House, 230-234 Lavender Hill, London SW11 1LE
T: 020 7228 5070 F: 020 7228 5030 E: info@bollingbrook.com

This document should not be relied on or used in circumstances other than those for which it was originally prepared and for which Bollingbrook was commissioned. Bollingbrook accepts no responsibility for this document to any other party other than the person by whom it was commissioned.

Title
Open Plan Layout

Date	Drawn	Checked	Paper	Scale	Status
July 2003	N.S.R.	GR	A1	1:100	Record

Project
Ground Floor, City Reach,
Millharbour, Docklands

Drawing no. 2321/DB/NR/007 Rev. A

C I T Y R E A C H